


- NOTES:
- THIS DRAWING WAS COMPILED FROM INFORMATION PROVIDED BY WANZEK, UTILIZING INFORMATION FROM THE FOLLOWING FILE LIST.
 - CRM_AvoidanceBuffer_110813.SHX
 - USFWS_WetEase_1012.SHX
 - Wetlands_Poly_102314.SHX
 - Courtenay_TurbineArrayRenumbering_2015_07_15.SHX
 - Courtenay ALTA 150120.DWG
 - Courtenay_CollectionRecordLines_20161108.SHP
 - Courtenay_AdditionalSurveyCorridor_2015_10_07.kmz
 - THE AERIAL WAS OBTAINED BY ULTEIG.
 - CourtenayAerial_NDStateplane_HarrNAD83_South_IntlFt.SID

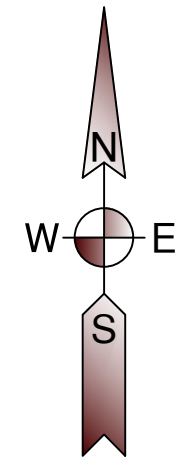


RECORD DRAWING
DRAWINGS ARE BASED UPON
CONSTRUCTION CONTRACTOR REDLINES
WHICH HAVE NOT BEEN FIELD VERIFIED BY
ENGINEER OF RECORD.

LEGEND

- XX WIND TURBINE
- F1 FEEDER 1
- F2 FEEDER 2
- F3 FEEDER 3
- F4 FEEDER 4
- F5 FEEDER 5
- F6 FEEDER 6
- F7 FEEDER 7
- F8 FEEDER 8
- F0C FIBER ROUTE
- SURVEYED CORRIDORS
- RIGHT OF WAY
- NON LEASED
- XJBX JUNCTION BOX
- SPLX-X CABLE SPLICE
- FSX-X FIBER SPLICE
- GRDX-X MID SPAN GROUND
- ACCESS ROADS
- BORE LOCATION [RB X-X]

NO	REVISION	ZONE	DATE	BY	CHK	ENG	NO	REVISION	ZONE	DATE	BY	CHK	ENG	REFERENCE DRAWINGS		
														DWG NO.	MANUFACTURER	DESCRIPTION
A	90% SUBMITTAL		10/12/2015	MJ	JH	BG										
0	ISSUED FOR CONSTRUCTION		01/22/2016	AS	JH	BG										
1	REVISED KEY MAP		02/10/2016	CL	JH	BG										
2	UPDATED CORRIDORS AND ROUTE		06/07/2016	BG	JH	BG										
3	RECORD DRAWING		12/05/2016	GP	JH	BG										

<div> Xcel Energy</div> <div>NORTHERN STATES POWER</div> <div>COURTENAY WIND - COLLECTION SYSTEM</div> <div>STUTSMAN COUNTY, NORTH DAKOTA</div>				<div>THIS MAP/DOCUMENT IS A TOOL TO ASSIST EMPLOYEES IN THE PERFORMANCE OF THEIR JOBS. YOUR PERSONAL SAFETY IS PROVIDED FOR BY USING SAFETY PRACTICES, PROCEDURES, AND EQUIPMENT AS DESCRIBED IN THE SAFETY TRAINING PROGRAMS AND MANUALS.</div>				<div>UNIT 0</div> <div>FEEDER ROUTING DIAGRAM</div> <div>SECTION 32, T143N, R62W</div>	
DWN: MJ	DATE:01/22/2016	CHK:	DATE:	ENERGY SUPPLY ENGINEERING & CONSTRUCTION				NH-271536-41	REV 3
ENG: BG	DATE:01/22/2016	CHK:	DATE:						
PM: BD	DATE:01/22/2016	PROJ. NO: 121901101							
APVD:	DATE:	SCALE:NONE							